


COPYRIGHT:
CTRL ALT DESIGN CO IS THE PROPRIETOR OF ALL RIGHTS INCLUDING COPYRIGHT ON THIS MATERIAL. NO REPRODUCTIONS ARE PERMITTED WITHOUT OUR WRITTEN CONSENT.

PLEASE NOTE:
CONTRACTORS NEED TO DO A SITE CHECK PRIOR TO ANY MANUFACTURE TO CONFIRM THE SIZES AS WILL NOT BE HELD LIABLE FOR INCORRECT SIZES. ANY DISCREPANCIES OR VARIATION REQUIREMENTS NOTICED ON SITE TO BE REPORTED TO THE PROJECT MANAGERS.
THIS DRAWING IS NOT TO BE USED FOR CONSTRUCTION PURPOSES.

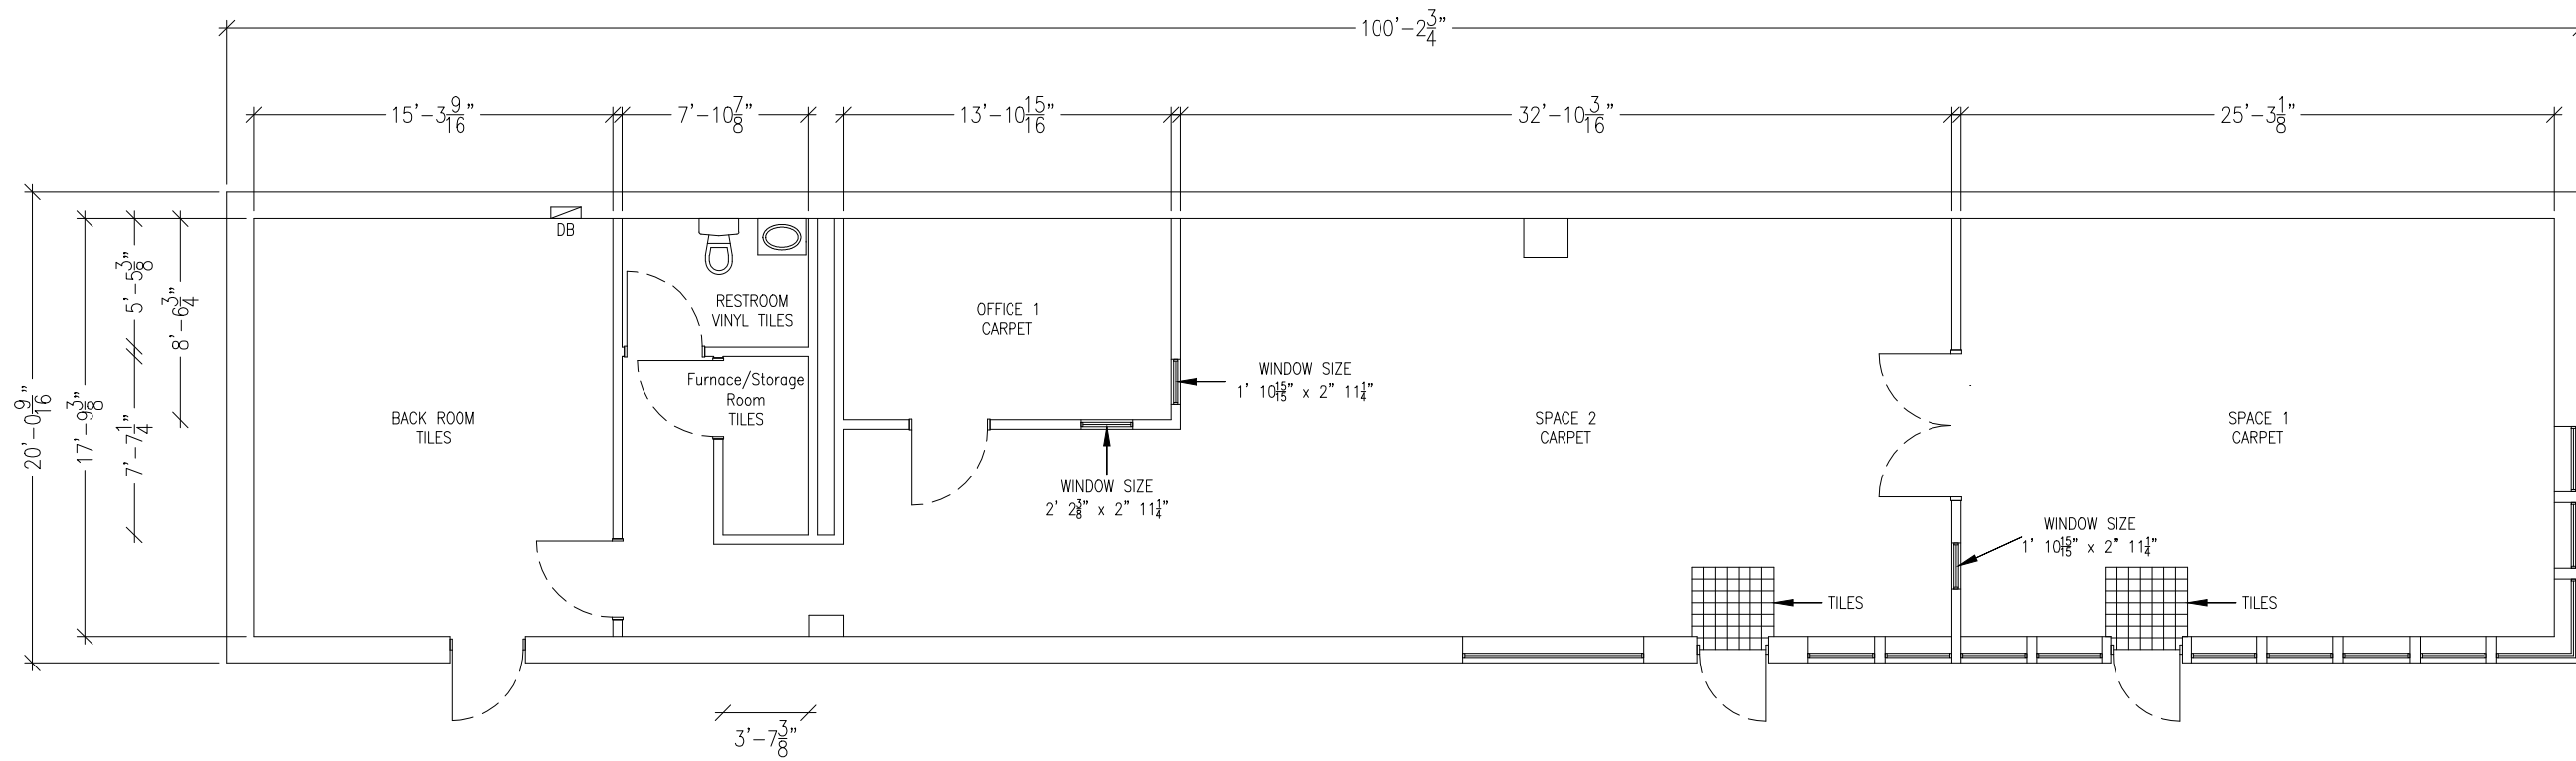

135 CONNECTOR ROAD
GEORGETOWN
40324
KENTUCKY

EMAIL: DONOVANPUDNEY@GMAIL.COM
CELL: +18655821552



PROJECT TITLE
280 VERSAILLES ROAD
FRANKFORT
40601
KENTUCKY

DRAWING TITLE
As-Built Floor Layout

DATE	DRAWN	CHECKED	SCALE
03.08.2018	DP	DP	1:50
PROJECT NO.	DWG NO.	EDITION NO.	REVISION
280V 1	280V 1	1	2